



GENERAL SHEET NOTES


- REFER TO DRAWING C-502 FOR THE GENERAL PROJECT NOTES, SPECIFICATIONS AND MATERIALS SCHEDULES.
- REFER TO DRAWING C-501 FOR THE GENERAL PROJECT NOTES, SPECIFICATIONS AND MATERIALS SCHEDULES.

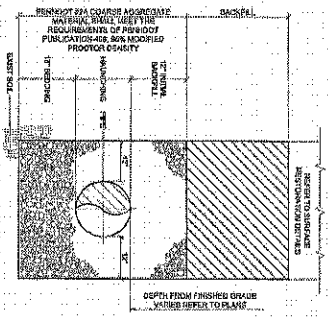


1 TYPICAL TRENCH RESTORATION DETAIL
SCALE: NONE

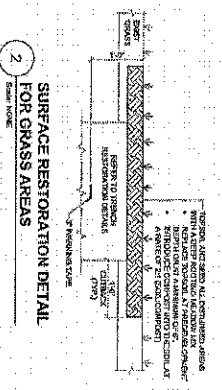


2 SURFACE RESTORATION DETAIL FOR GRASS AREAS
SCALE: NONE

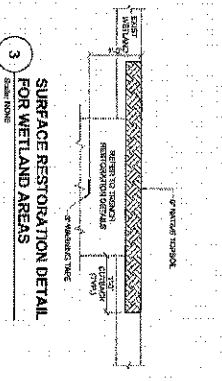


3 SURFACE RESTORATION DETAIL FOR WETLAND AREAS
SCALE: NONE

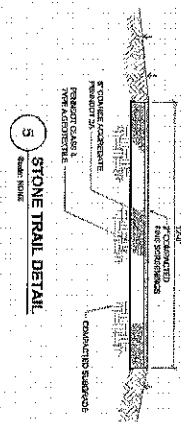


4 SURFACE RESTORATION DETAIL FOR PAVED DRIVEWAY
SCALE: NONE

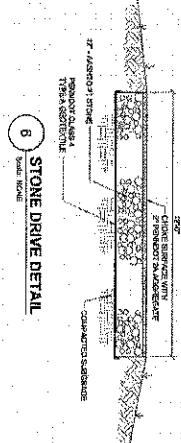


5 STONE TRAIL DETAIL
SCALE: NONE

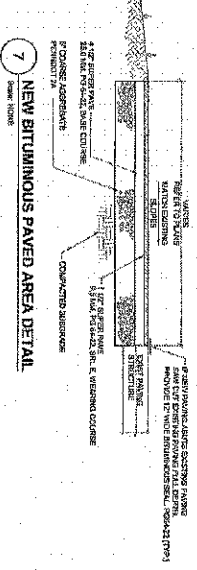


6 STONE DRIVE DETAIL
SCALE: NONE

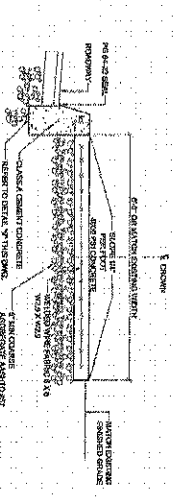


7 NEW BITUMINOUS PAVED AREA DETAIL
SCALE: NONE

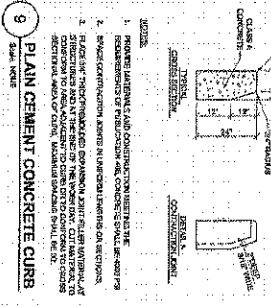


8 CURB & SIDEWALK REPLACEMENT DETAIL
SCALE: NONE

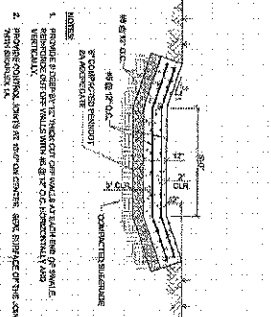

9 PLAIN CEMENT CONCRETE CURB
SCALE: NONE

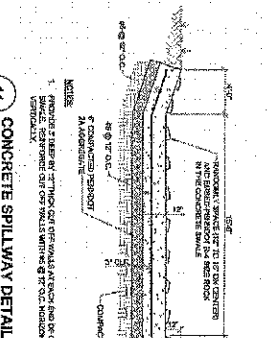

10 CONCRETE SMALL DETAIL
SCALE: NONE

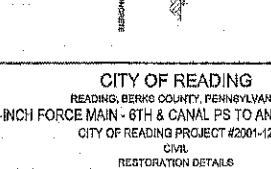

11 CONCRETE SPILLWAY DETAIL
SCALE: NONE

CITY OF READING
READING, BERKS COUNTY, PENNSYLVANIA
42-INCH FORCE MAIN - 6TH & CANAL PS TO ANGELICA CREEK
CITY OF READING PROJECT #2001-12
CIVIL
RESTORATION DETAILS

NO.	DATE	REV.	BY	CHK.	APP.
1	11/04/14				

RECORD DRAWING
AS-BUILT
DATE 08/11/2014

ENTECH ENGINEERING 1.695.826.1403
www.entechee.com

Reading, Pennsylvania
4200 Park Road, Suite 100, Reading, PA 19604
1100 Park Road, Suite 100, Reading, PA 19604
1100 Park Road, Suite 100, Reading, PA 19604

C-502